


SITE PLAN

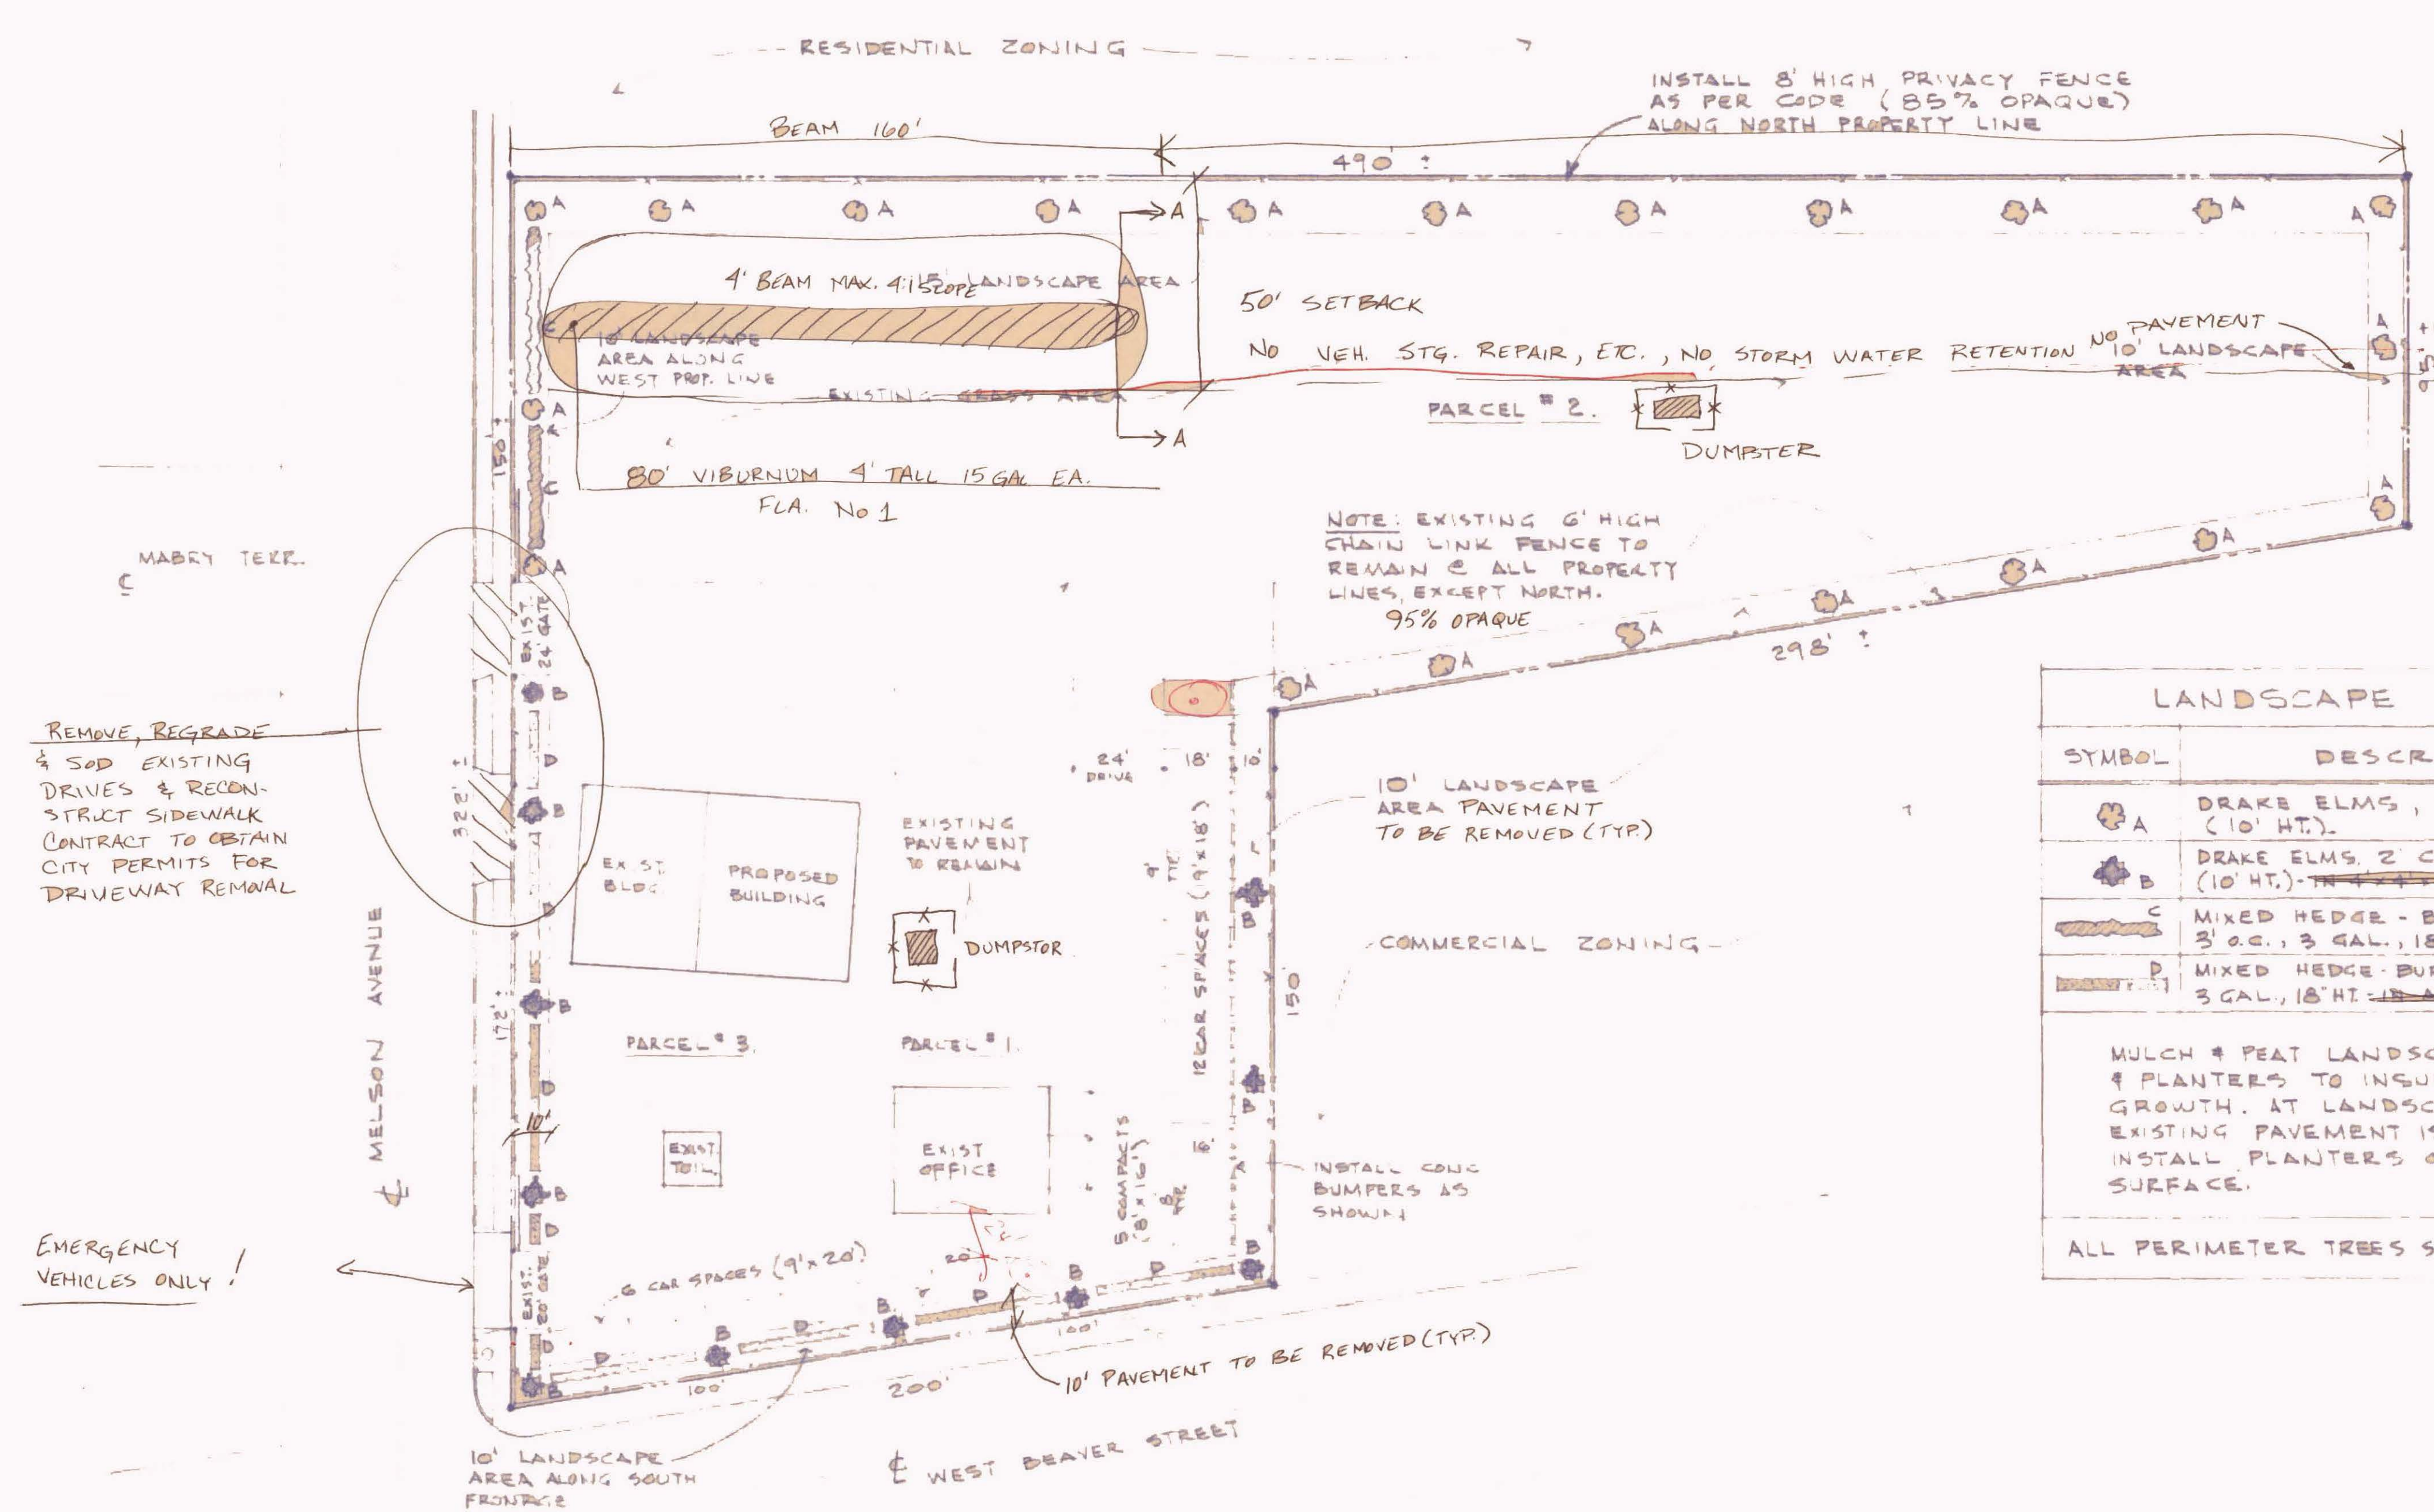

| LANDSCAPE LEGEND | |
|------------------|---|
| SYMBOL | DESCRIPTION |
| | DRAKE ELMS, 2" CAPILER DIA. (10' HT.) |
| | DRAKE ELMS, 2" CAPILER DIA. (10' HT.) - 1/2" CAPILER DIA. (10' HT.) |
| | MIXED HEDGE - BURFORD HOLLY, 3' O.C., 3 GAL., 18" HT. |
| | MIXED HEDGE - BURFORD HOLLY, 3' O.C., 3 GAL., 18" HT. - 1/2" CAPILER DIA. (10' HT.) |

MULCH & PEAT LANDSCAPE BED AREAS & PLANTERS TO INSURE PLANT GROWTH. AT LANDSCAPE AREAS WHERE EXISTING PAVEMENT IS TO REMAIN, INSTALL PLANTERS ON PAVEMENT SURFACE.

ALL PERIMETER TREES SHALL BE 50' O.C. (MAX)


LEGAL

SUNNY BROOK GARDENS - FARMS
E 100 FT. OF W. 200 FT. OF S. 150 FT.
TRACT 3, BEING PARCEL 1, O/R 7765-766.

SUNNY BROOK GARDENS - FARMS
PT. TRACT 3 RECD. O/R 7765-766
BEING PARCEL 2.

SUNNY BROOK GARDENS - FARMS
PT. TRACT 3 RECD. O/R 7765-766
BEING PARCEL 3.

SITE PLAN
SCALE: 1" = 30'

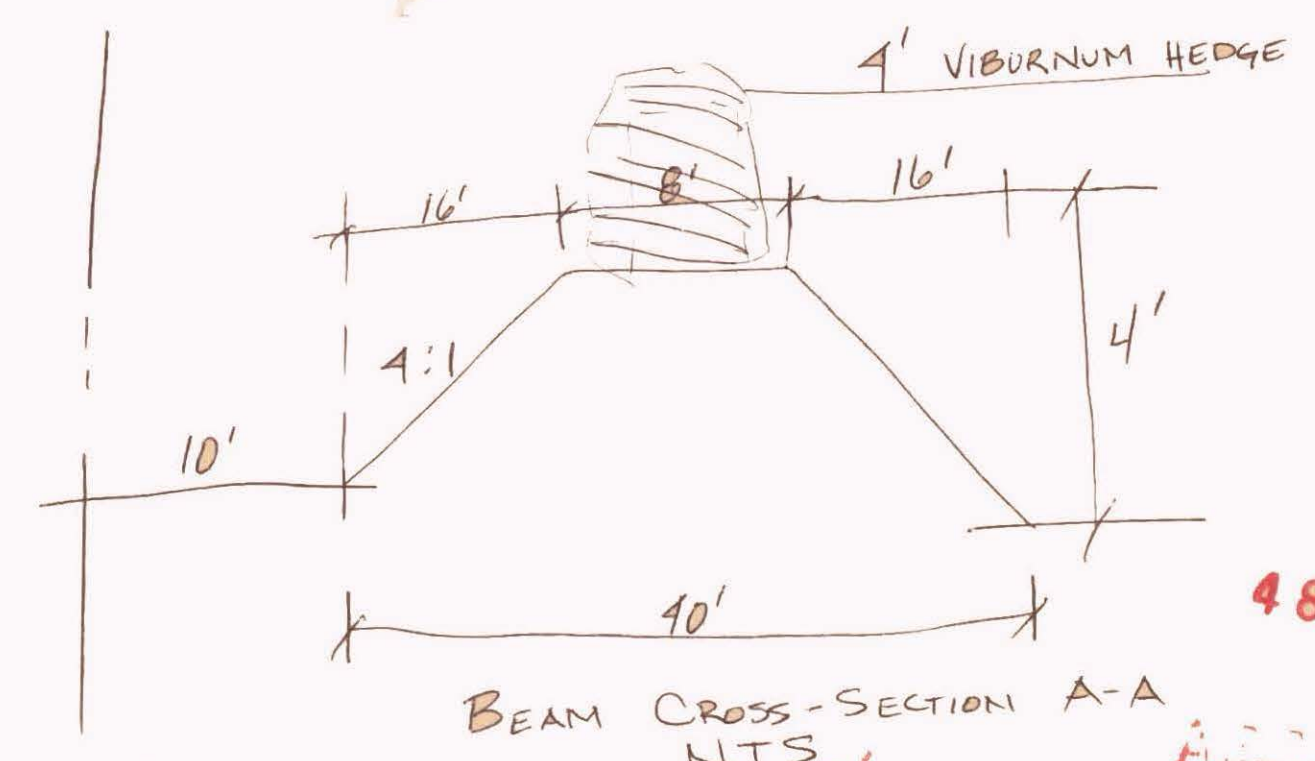

LANDSCAPE SECTION

BY: DATE:

APPROVED

APPROVED AS NOTED

REVISE & RESUBMIT

12/14/15

48299

APPROVED

12/14/15

Building & Zoning Inspection Div.

Robert C. Miller
12-14-15

November 19, 2015
Exhibit 3x4
Page 1 of 1